


PLAT OF SURVEY

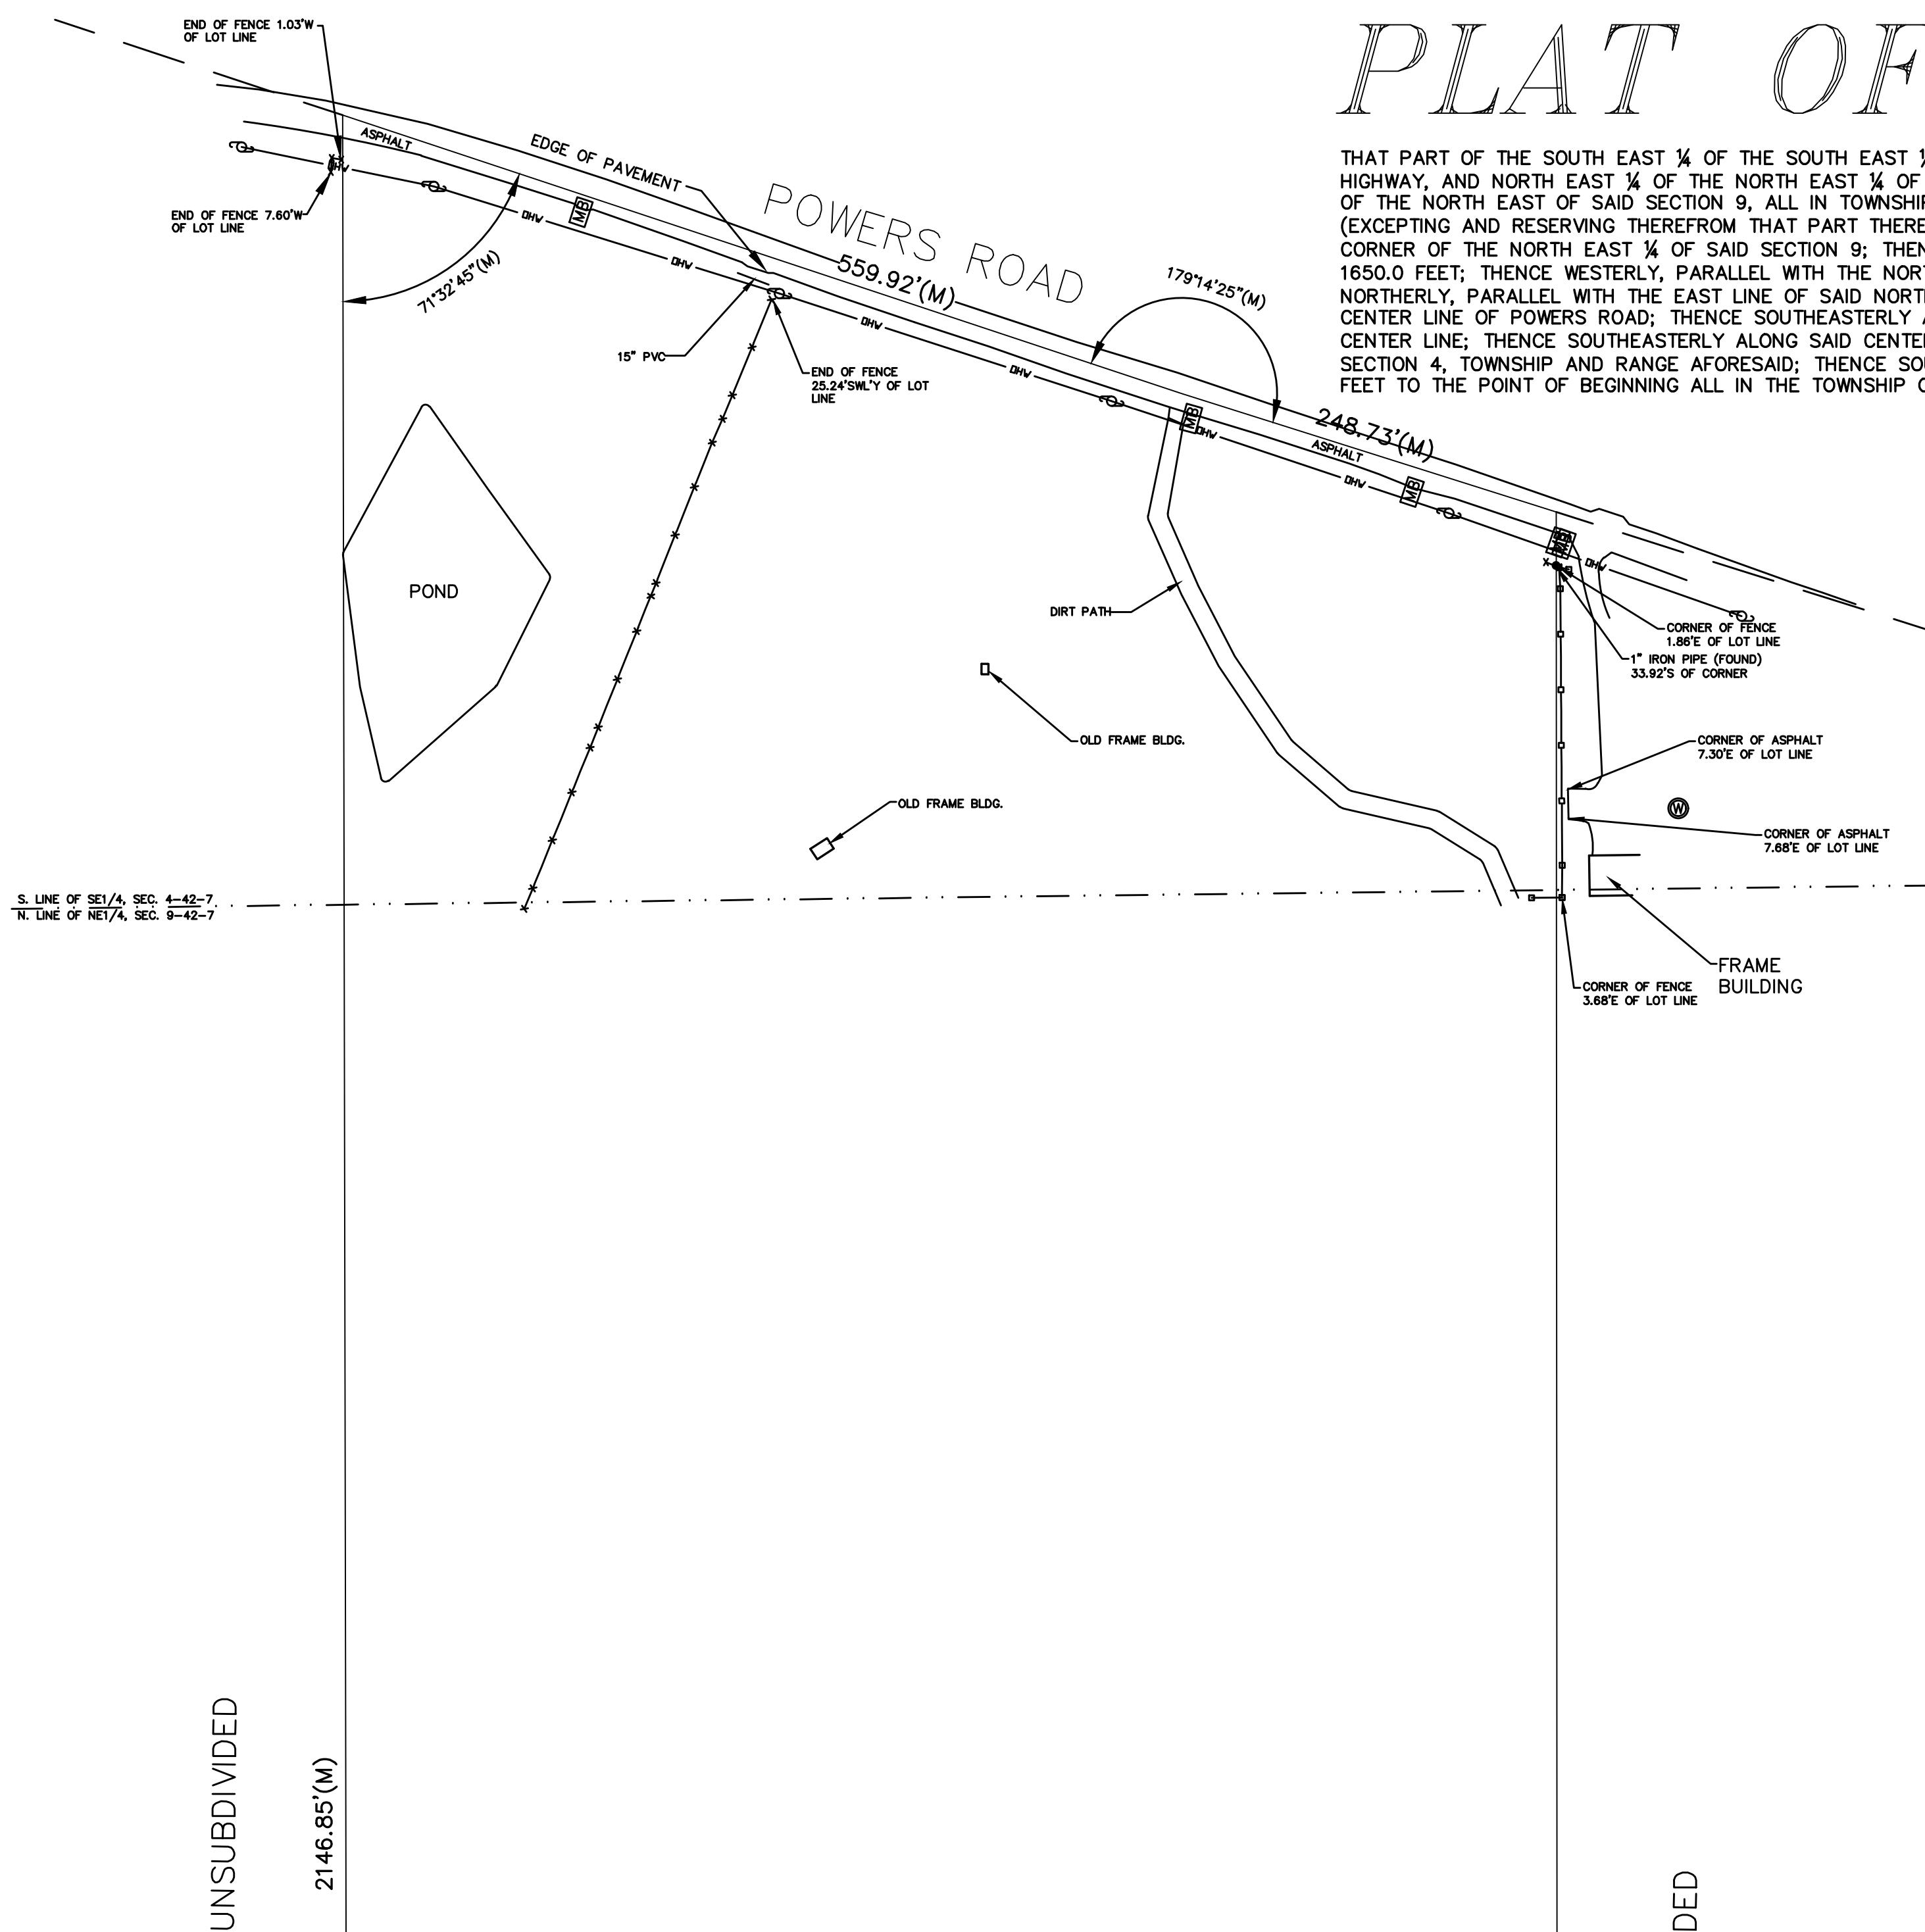

THAT PART OF THE SOUTH EAST $\frac{1}{4}$ OF THE SOUTH EAST $\frac{1}{4}$ OF SECTION 4 LYING SOUTHERLY OF THE CENTER LINE OF THE HIGHWAY, AND NORTH EAST $\frac{1}{4}$ OF THE NORTH EAST $\frac{1}{4}$ OF SECTION 9, AND THE NORTH 10 ACRES OF THE SOUTH EAST $\frac{1}{4}$ OF THE NORTH EAST $\frac{1}{4}$ OF SAID SECTION 9, ALL IN TOWNSHIP 42 NORTH, RANGE 7 EAST OF THE PRINCIPAL MERIDIAN (EXCEPTING AND RESERVING THEREFROM THAT PART THEREOF DESCRIBED AS FOLLOWS: BEGINNING AT THE NORTH EAST CORNER OF THE NORTH EAST $\frac{1}{4}$ OF SAID SECTION 9; THENCE SOUTHERLY ALONG THE EAST LINE OF SAID NORTH EAST $\frac{1}{4}$ 1650.0 FEET; THENCE WESTERLY, PARALLEL WITH THE NORTH LINE OF SAID NORTH EAST $\frac{1}{4}$, 538.85 FEET; THENCE NORTHERLY, PARALLEL WITH THE EAST LINE OF SAID NORTH EAST $\frac{1}{4}$ AND SAID EAST LINE EXTENDED, 1882.59 FEET TO THE CENTER LINE OF POWERS ROAD; THENCE SOUTHEASTERLY ALONG SAID CENTER LINE, 75.60 FEET TO AN ANGLE IN SAID CENTER LINE; THENCE SOUTHEASTERLY ALONG SAID CENTER LINE 493.79 FEET TO THE EAST LINE OF THE SOUTH EAST $\frac{1}{4}$ OF SECTION 4, TOWNSHIP AND RANGE AFORESAID; THENCE SOUTHERLY ALONG THE EAST LINE OF SAID SOUTH EAST $\frac{1}{4}$ 31.45 FEET TO THE POINT OF BEGINNING ALL IN THE TOWNSHIP OF RUTLAND, KANE COUNTY, ILLINOIS.

LAND TECHNOLOGY
ASSUMED MERIDIAN


UNSUBDIVIDED

2146.85' (M)

UNSUBDIVIDED

1883.41' (M)

AREA = 35.51 ACRES
PIN: 02-09-200-002 & 02-04-400-009

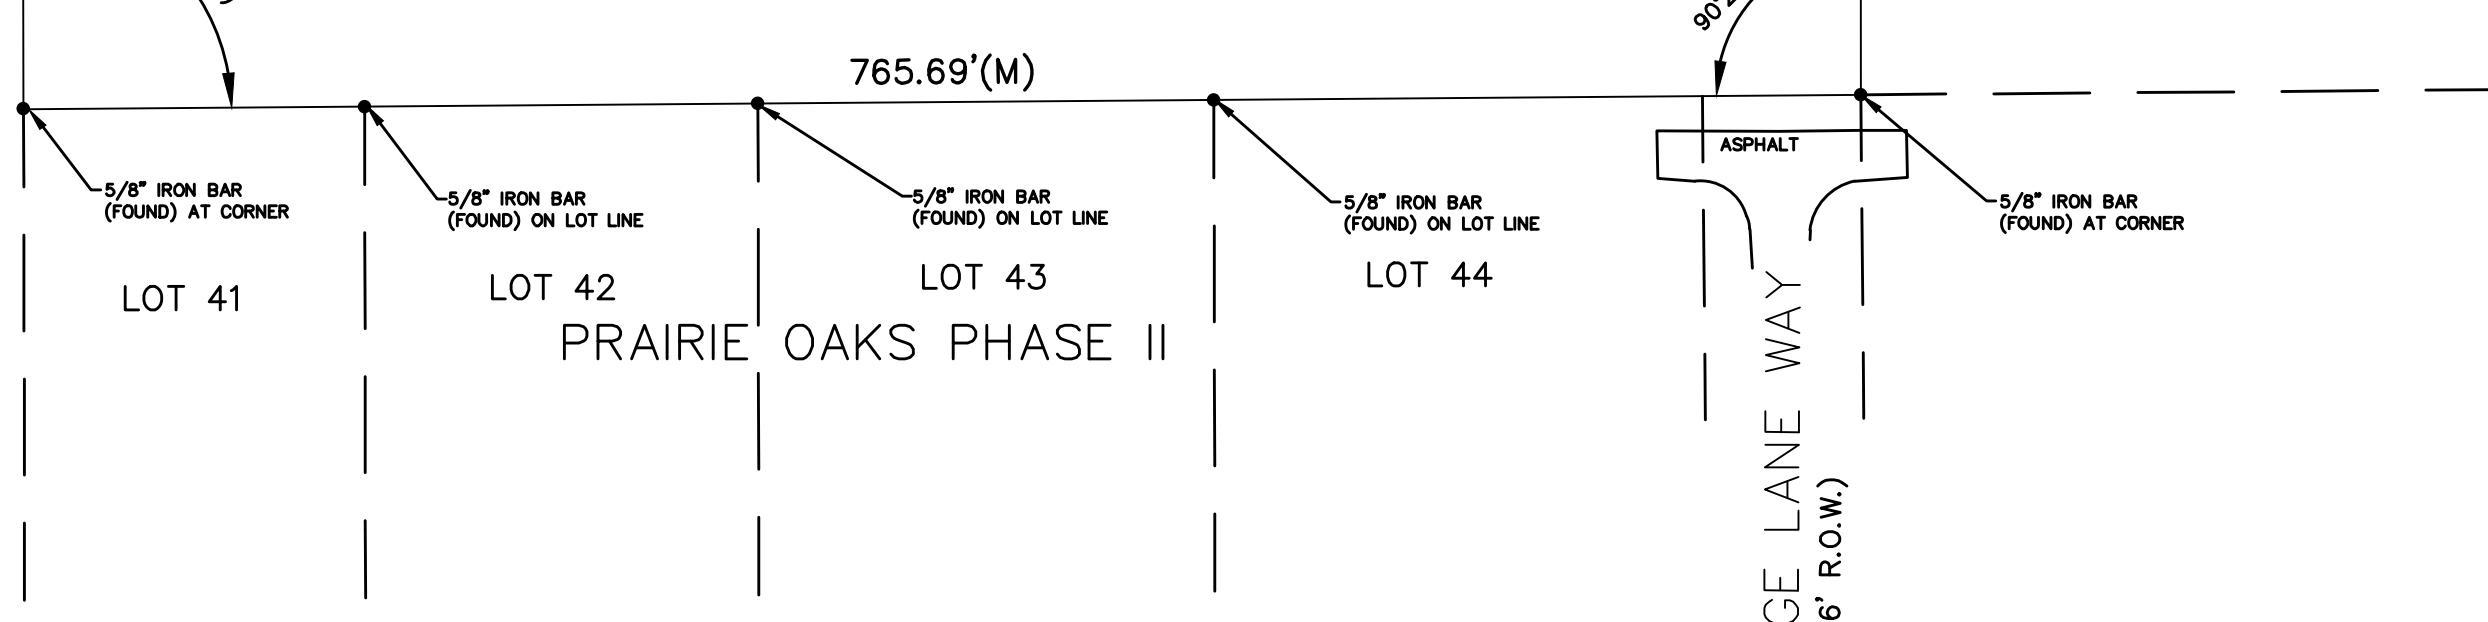

SYMBOL LEGEND	
WELL	WELL
UTILITY POLE	UTILITY POLE
MAILBOX	MAILBOX

LINE LEGEND	
* * *	= BARBED WIRE FENCE
- - - - -	= WOOD FENCE

LEGEND
• = FOUND MONUMENTATION
(M) = MEASURED DIMENSION

NOTE: BUILDING TIE DIMENSIONS SHOULD NOT BE USED TO DETERMINE LOT LINE LOCATIONS. REFER TO ACTUAL LOT CORNERS AND REPORT ANY DIFFERENCES TO THE SURVEYOR IMMEDIATELY.

ALL LOT DIMENSIONS ARE RECORD UNLESS OTHERWISE NOTED.

FIELD WORK COMPLETED 04/14/05.

STATE OF ILLINOIS } S.S.

COUNTY OF McHENRY }

THIS PROFESSIONAL SERVICE CONFORMS TO THE CURRENT ILLINOIS MINIMUM STANDARDS FOR A BOUNDARY SURVEY.

DIMENSIONS ARE SHOWN IN FEET AND DECIMAL PARTS THEREOF.
HEREBY CERTIFY THAT A SURVEY HAS BEEN MADE UNDER MY DIRECTION AND SUPERVISION OF THE PROPERTY DESCRIBED ABOVE, AND THAT THE PLAT HEREON DRAWN IS A CORRECT REPRESENTATION OF SAID SURVEY.

DATED THIS 17TH DAY OF MAY, A.D. 2005.

JEFFERSON J. BRAZAS ILLINOIS PROFESSIONAL LAND SURVEYOR 35-3538
LAND TECHNOLOGY INC., ILLINOIS PROFESSIONAL DESIGN FIRM

LICENSE EXPIRES 11/30/06



BOUNDARY SURVEY:		
PT. OF SE 1/4 OF SEC 4 & PT OF NE 1/4 SEC. 9		
SCALE: 1" = 80'	I:\05\05209\BNDRY-SURVEY.DWG	DRAWN BY: LLP/JJB
DATE: 05/16/05		FIELD CREW: F2/JJB
LAND TECHNOLOGY, INC. (815)363-9200		
3922 W. MAIN STREET McHENRY, IL. 60050		ILLINOIS PROFESSIONAL DESIGN FIRM No. 184-001331
LOCATION: KANE COUNTY	CLIENT: CABA	DRAWING NUMBER: 05-209